
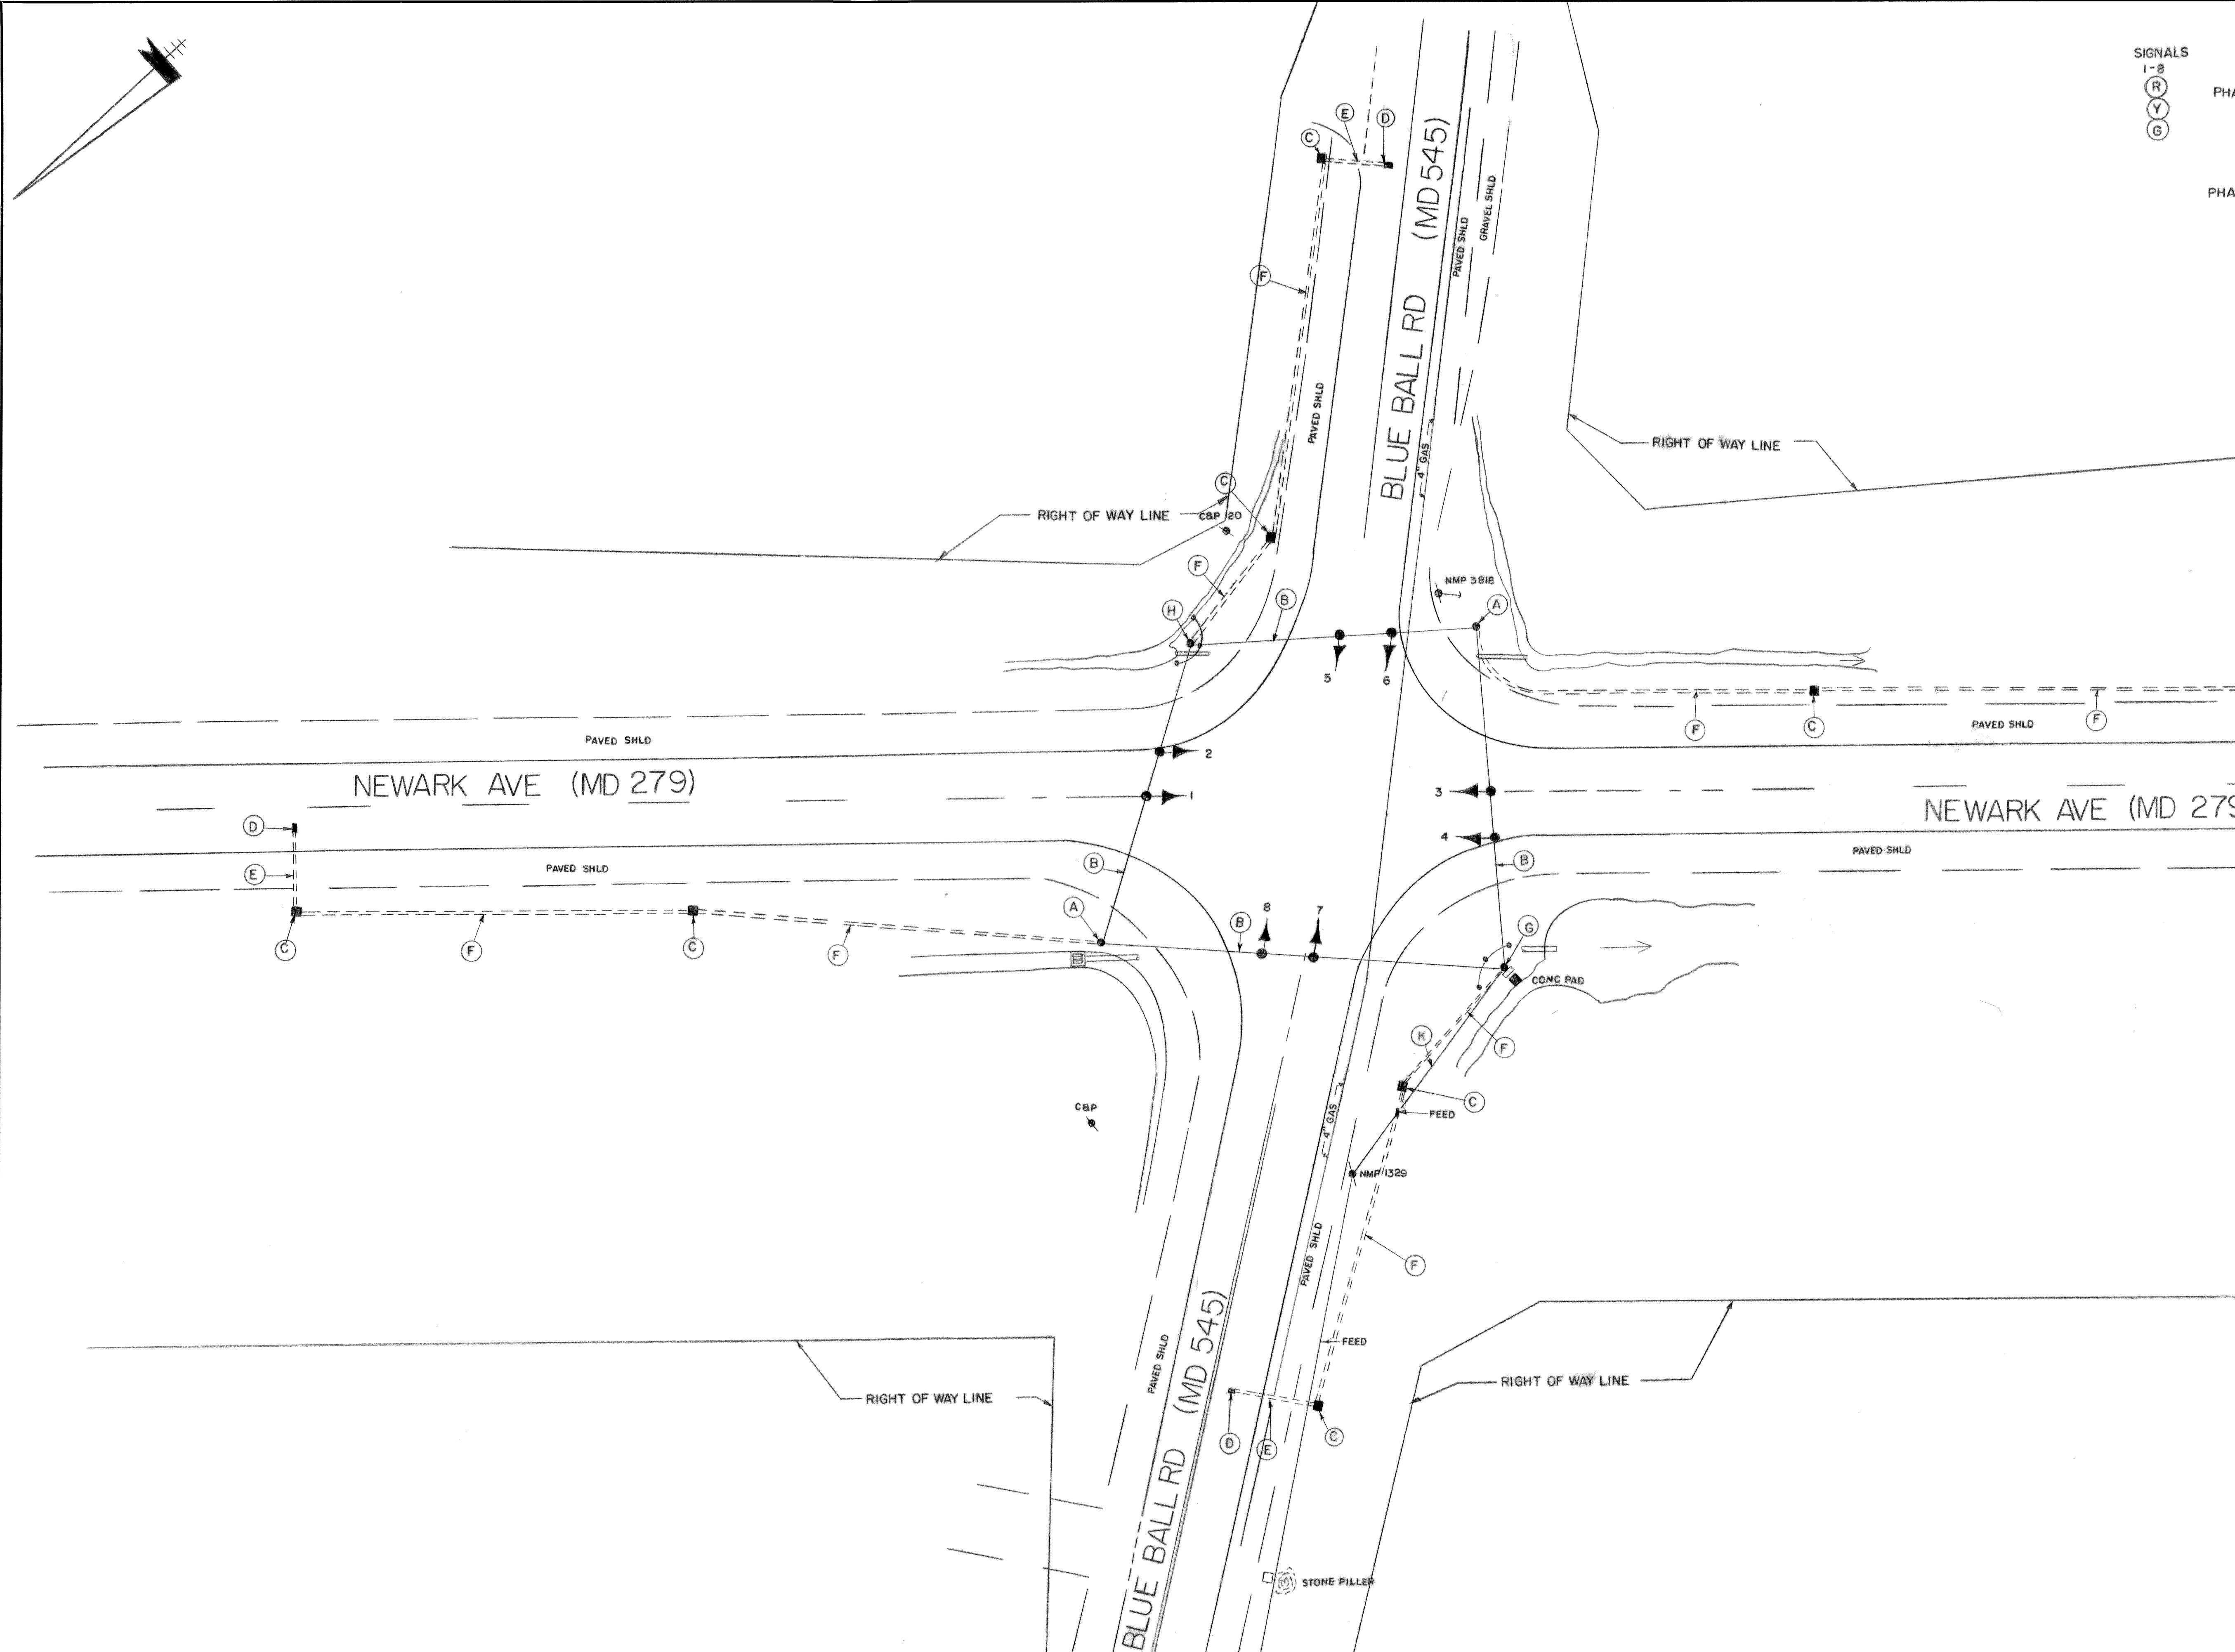


F.H.W.A. REGION NO.	STATE	FED. AID PROJ. NO.	SHEET NO.	TOTAL SHEETS
3	MD.			

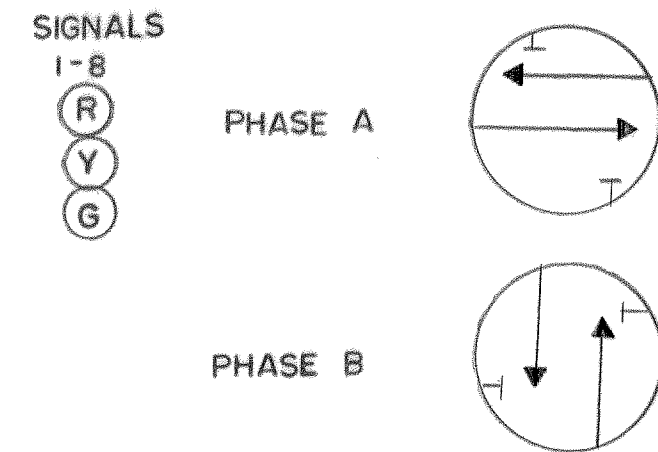

APPROVAL: CHIEF SIGNAL DESIGN SECTION	
APPROVAL: REGIONAL TRAFFIC ENGINEER	
APPROVAL: CHIEF-BUREAU OF TRAFFIC ENGINEERING	B 6-24-83 RE-DRAWN
APPROVAL: ASST. CHIEF ENGINEER TRAFFIC	A ASBUILT 7-7-82 CE-526X-275
	REVISIONS

STATE OF MARYLAND
DEPARTMENT OF TRANSPORTATION
STATE HIGHWAY ADMINISTRATION
TRAFFIC DIVISION - BUREAU OF TRAFFIC ENGINEERING

MD 279 (g) MD 545

SCALE: 1" = 20' DATE: 4-10-72 CONTRACT NO.

DRAWN BY: LES TOWNSEND COUNTY: CECIL

DESIGNED BY: SIGNAL NO.: 07101

CHECKED BY: DRAWING NO. TS-210B